
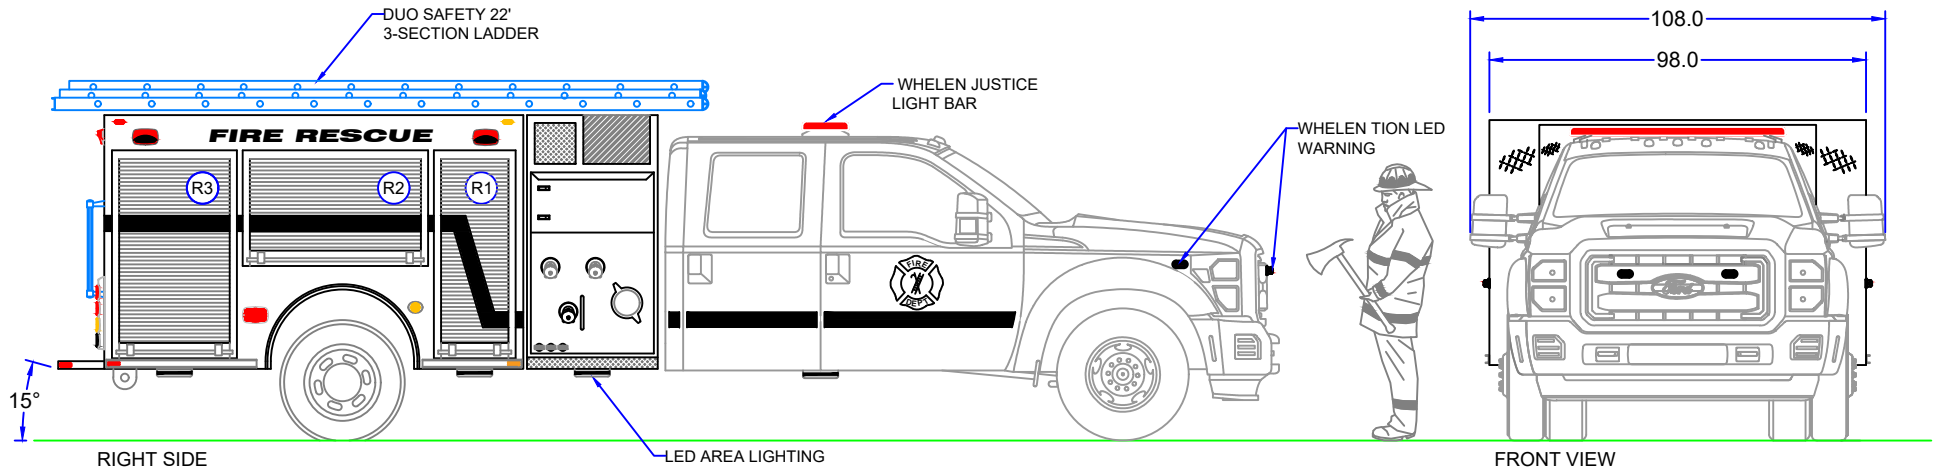


# PROPOSAL DRAWING

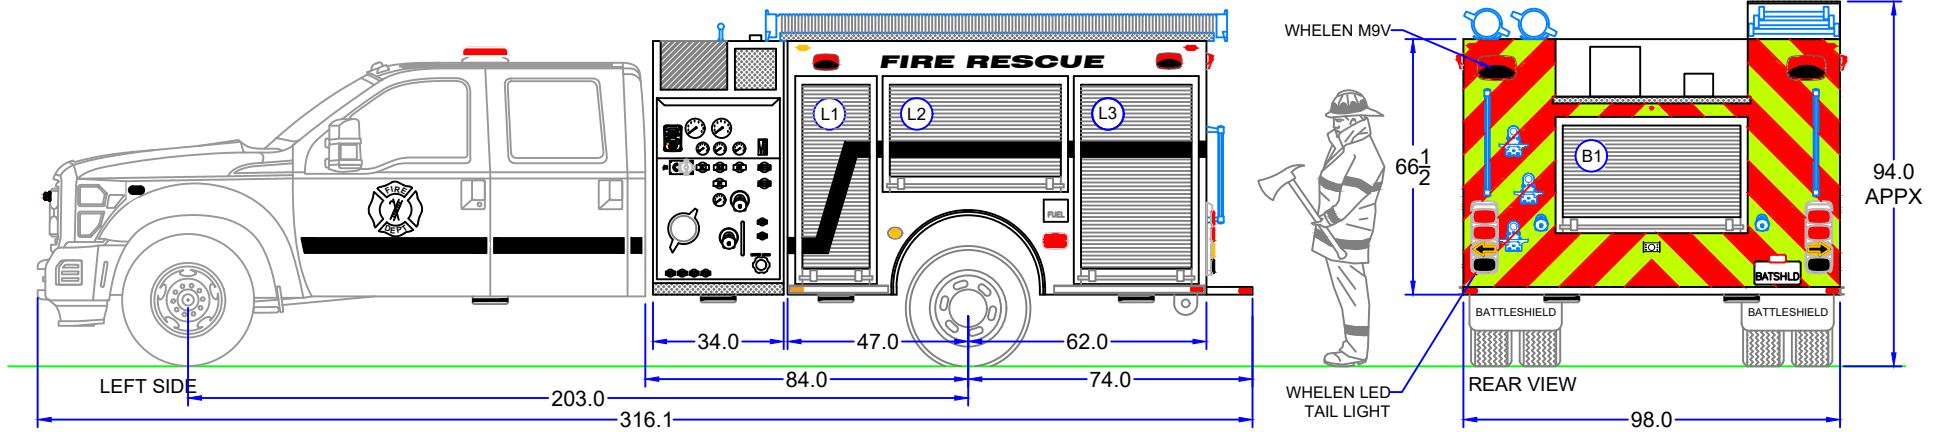

## MINI PUMPER

**CAB**  
CHASSIS 2019 F550 4X4 SD CREW  
ENGINE 6.7L POWER STROKE V8  
330 HP @ 2600 RPM  
750 FT/LBS 2000 RPM

TRANSMISSION 6 SPEED AUTOMATIC  
GVWR 19,500 LBS MAX  
FGAWR 7,500 LBS  
RGAWR 14,706 LBS

**TANK** 300 IGAL WATER (25 IGAL FOAM)  
BODY MAT'L 3/16" 5052 H32 ALM.  
1/8" 3003 H22 ALM. CHECKER PLATE NFPA

WHELEN LED LIGHT PACKAGE  
WHELEN LED SCENE LIGHTS  
AMDOR ROLL-UP DOORS  
ALL TRAYS & SHELVES INCLUDED

**PUMP** HALE DSD 1250 GPM

COMPARTMENT DIMENSIONS			
	WIDTH	HEIGHT	DEPTH
L1	24.875	62.25	23.75
L2	47.25	39.5	23.75
L3	33.75	62.25	23.75
R1	16.0	62.25	23.75
R2	47.25	39.5	23.75
R3	33.75	62.25	23.75
B1	50.0	33.0	32.0

ALL DIMENSIONS IN INCHES  
**DO NOT SCALE DRAWING**

**DISCLAIMER**  
We reserve the right to modify these dimensions to accommodate actual "as built" chassis dimensions. This was prepared using body builder reference drawings.

INSPECTED	DATE
L. THIBAUT	28 NOV. 2019
DRAWN	DATE
D. HE	28 NOV. 2019
LAST UPDATE	
As-Built	

