


# PUMPER TANKER

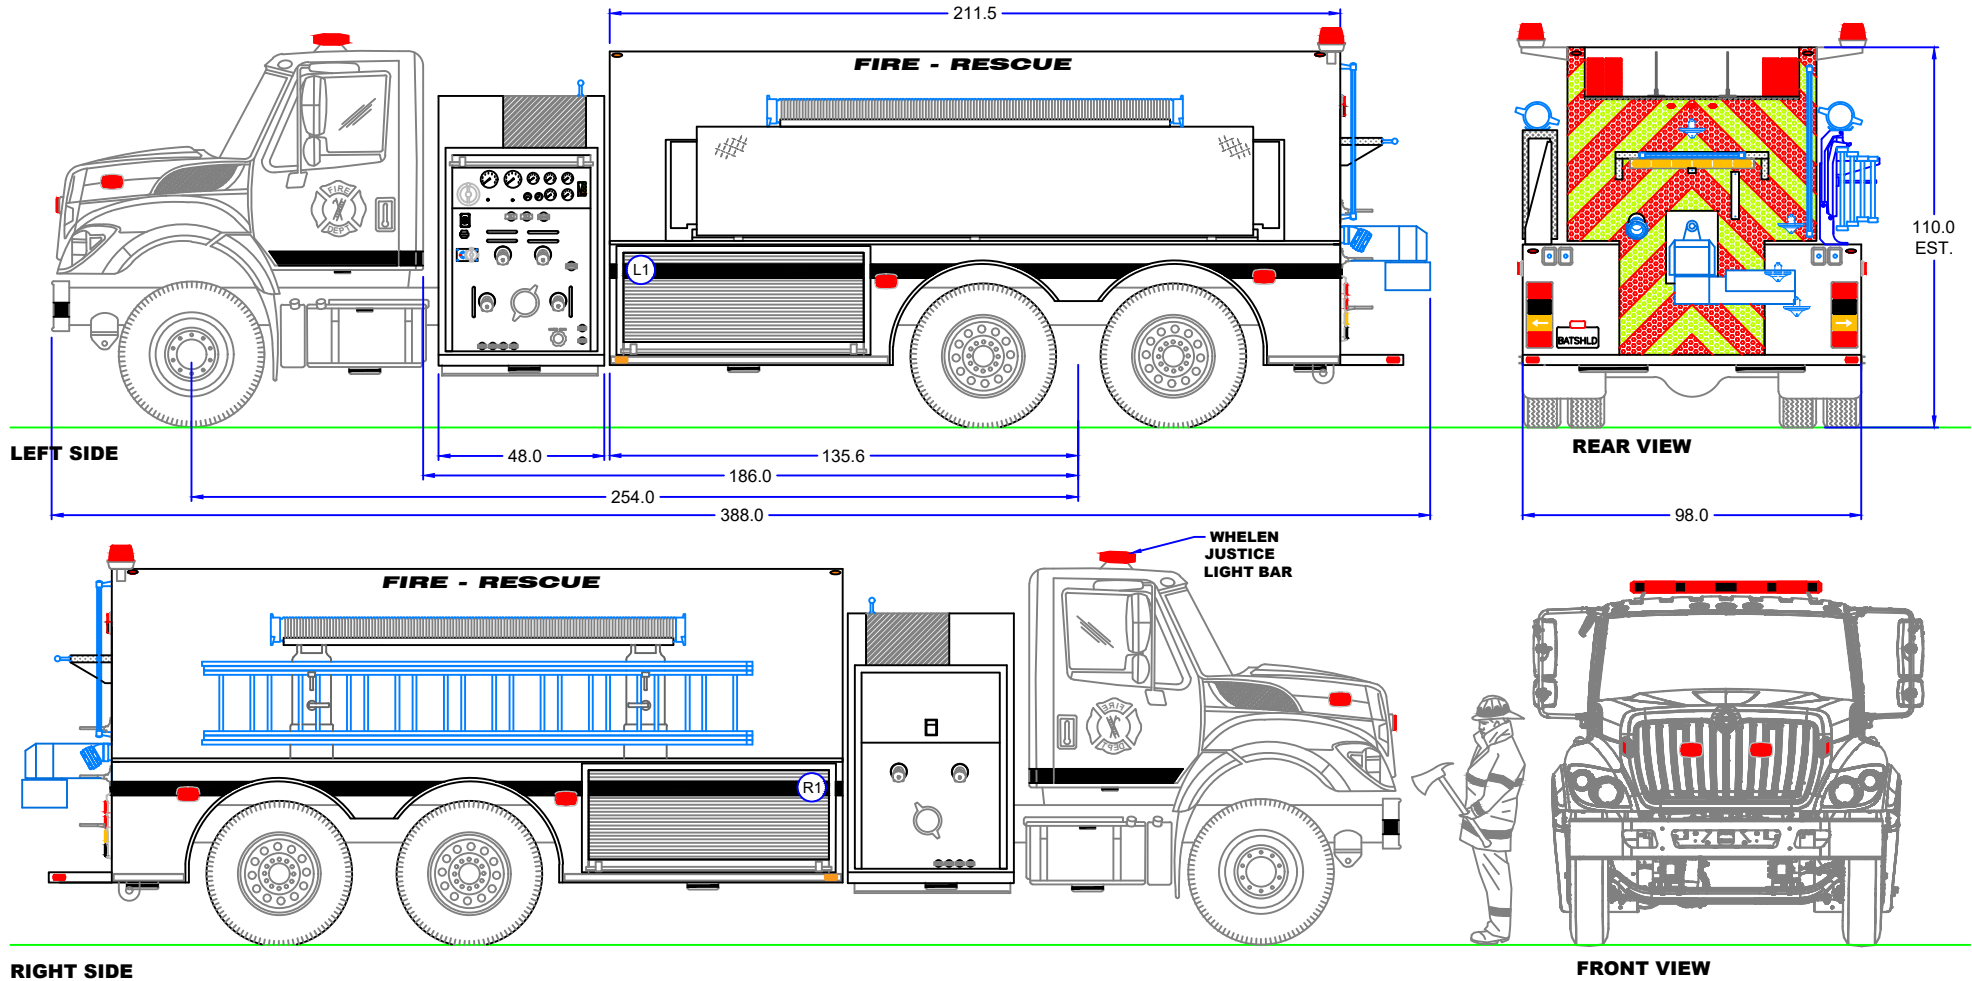

SOME OPTIONAL EQUIPMENT SHOWN

## STOCK PUMPER TANKER

**CAB**

CHASSIS INTERNATIONAL 7400 6X4  
 ENGINE DT530 330HP @ 2000 RPM  
 950 LB-FT @ 1400 RPM

TRANS ALLISON 3000 EVS-P AUTO

GVWR 58,000 LBS  
 FAWR 18,000 LBS  
 RAWR 40,000 LBS

**BODY**

BODY MAT'L 3/16" 5052-H32 MARINE GRADE ALUMINUM  
 CHECKER 1/8" 5052-H32 ALUMINUM CHECKER PLATE  
 DOORS SLAM DOORS

**OPTIONS**

ELECTRIC FOLDING PORT-A-TANK RACK  
 ELECTRIC DUMP VALVE WITH FLIP DOWN  
 SWIVEL CHUTE

**FIRE PUMP & WATER TANK**

FIRE PUMP HALE QMAX 150-23L 6000 LPM  
 LEFT SIDE OPERATOR PANEL

FOAM SYS N/A  
 TANK 2500 IGAL POLY WET-SIDE  
 NEWTON DUMP w/ SWIVEL & FLIP  
 EXTENSION

COMPARTMENT Dimensions			
	WIDTH	DEPTH	HEIGHT
L1	76.5	28.0	31.0
R1	76.5	28.0	31.0

ALL DIMENSIONS IN INCHES  
 UNLESS OTHERWISE SPECIFIED  
 DO NOT SCALE DRAWING

**DISCLAIMER**

We reserve the right to modify these dimensions  
 to accommodate actual "as built" chassis dimensions.  
 This was prepared using body builder reference  
 drawings.

DRAWN	DATE
D. BELL	04 SEPT 2019
REVISION	LAST UPDATE
As-Built	21 MAY 2020
APPROVED	
L. THIBAUT	

