


# DEMO P/T

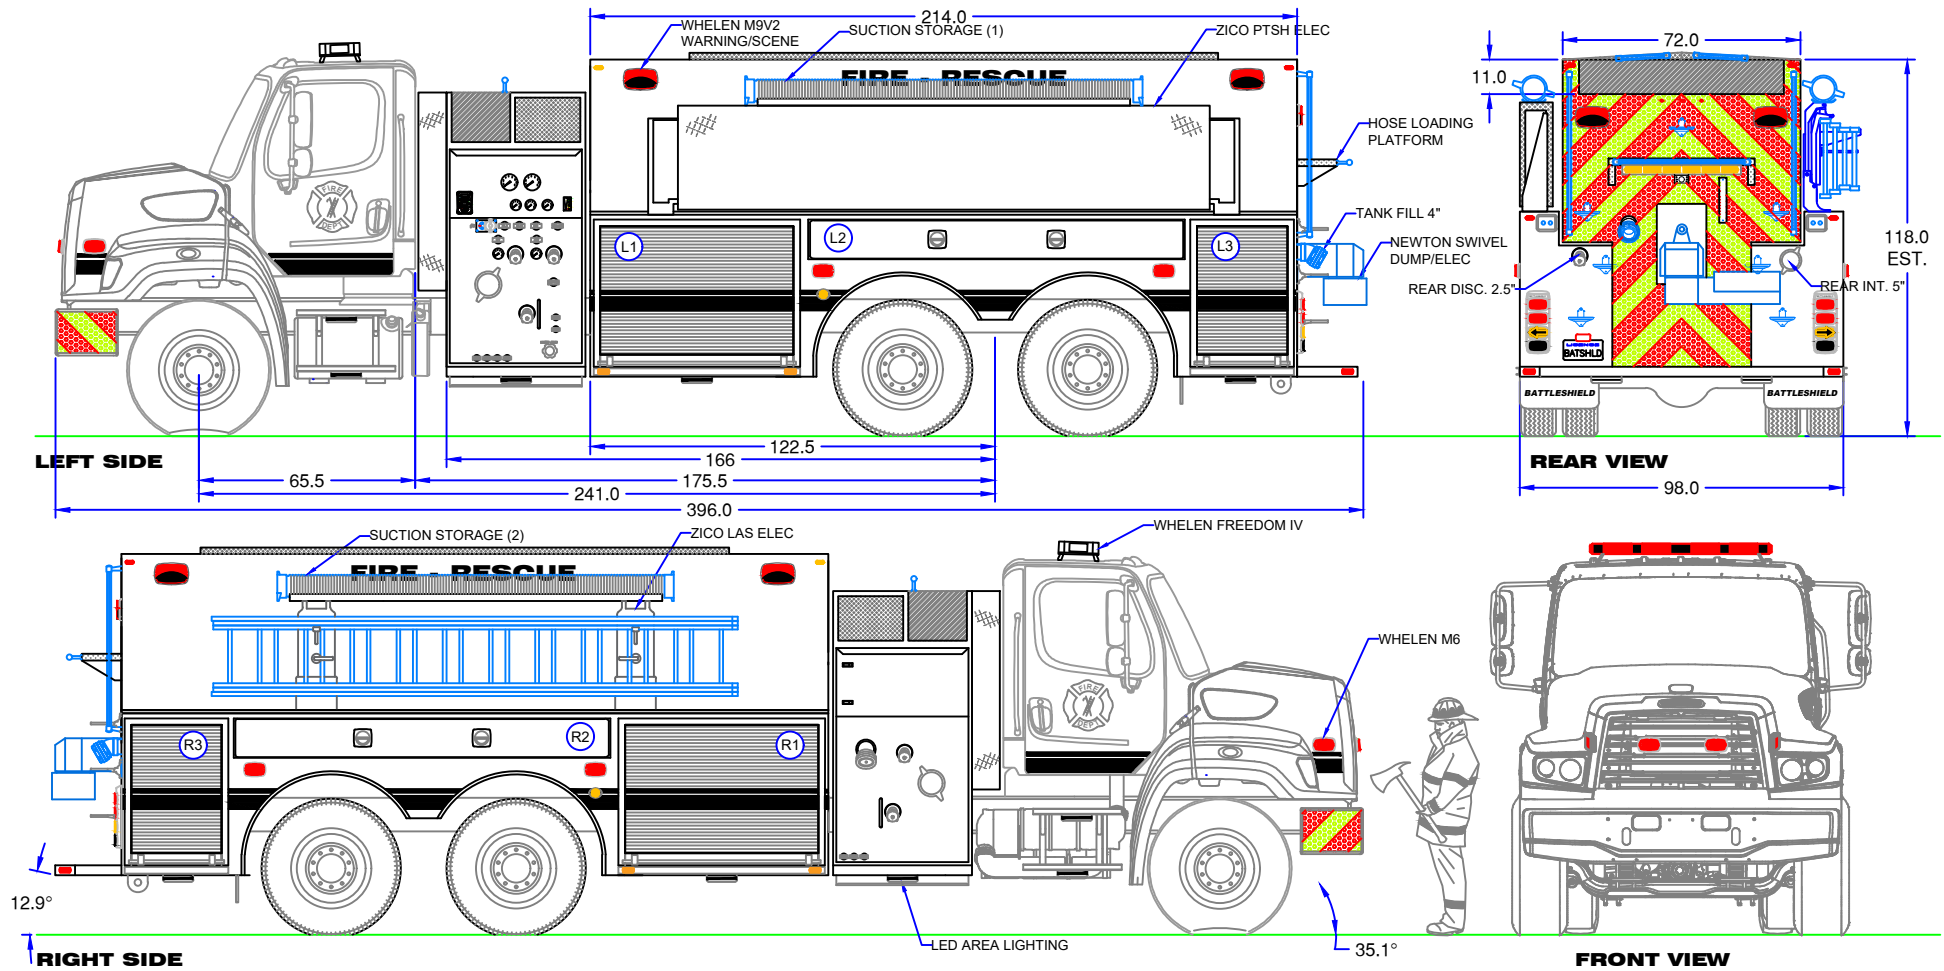

**CAB**  
 CHASSIS 2020 FREIGHTLINER 108 SD  
 ENGINE CUMMINS L9 EV  
 400 HP @ 2100 RPM  
 1250 FT/LBS @ 1400 RPM

**TRANS** ALLISON 3000 EVS-P AUTO  
**FAWR** 16,000 LBS  
**RAWR** 44,000 LBS  
**GAWR** 60,000 LBS

**BODY**  
 BODY MAT'L 3/16" 5052-H32 MARINE GRADE ALUMINUM  
 CHECKER 1/8" 3003H22 ALUMINUM CHECKER PLATE

**DOORS** AMDOR ROLL DOORS

**OPTIONS** ZICO ELECTRIC LADDER RACK  
 ZICO ELECTRIC PORT-A-TANK RACK  
 STORAGE FOR 2 X SUCTION HOSE  
 2 1/2" REAR DISCHARGE RIGHT SIDE

**FIRE PUMP & WATER TANK**  
 FIRE PUMP HALE DSD MIDSHIP 5000 LPM

**FOAM SYS** FOAMPRO 2001

**TANK** 2500 IGAL POLY WET-SIDE

**NOTE:** ALL TRAYS/SHELVES OPTIONAL

**COMPARTMENT Dimensions**

	WIDTH	DEPTH	HEIGHT
L1	64.0	28.0	46.0
L2	117.0	28.0	10.0
L3	34.0	28.0	46.0
R1	64.0	28.0	46.0
R2	117.0	28.0	10.0
R3	34.0	28.0	46.0

DO NOT SCALE DRAWING

**1336 DEMO PT-HIGH SIDE**

ALL DIMENSIONS IN INCHES UNLESS OTHERWISE SPECIFIED  
 DO NOT SCALE DRAWING

**DISCLAIMER**  
 We reserve the right to modify these dimensions to accommodate actual "as built" chassis dimensions. This was prepared using body builder reference drawings.

DRAWN	D. HE	DATE	23 NOV 2017
REVISED			
As-Built		09 AUG 2019	
APPROVED	L. THIBAUT		