


PROPOSAL

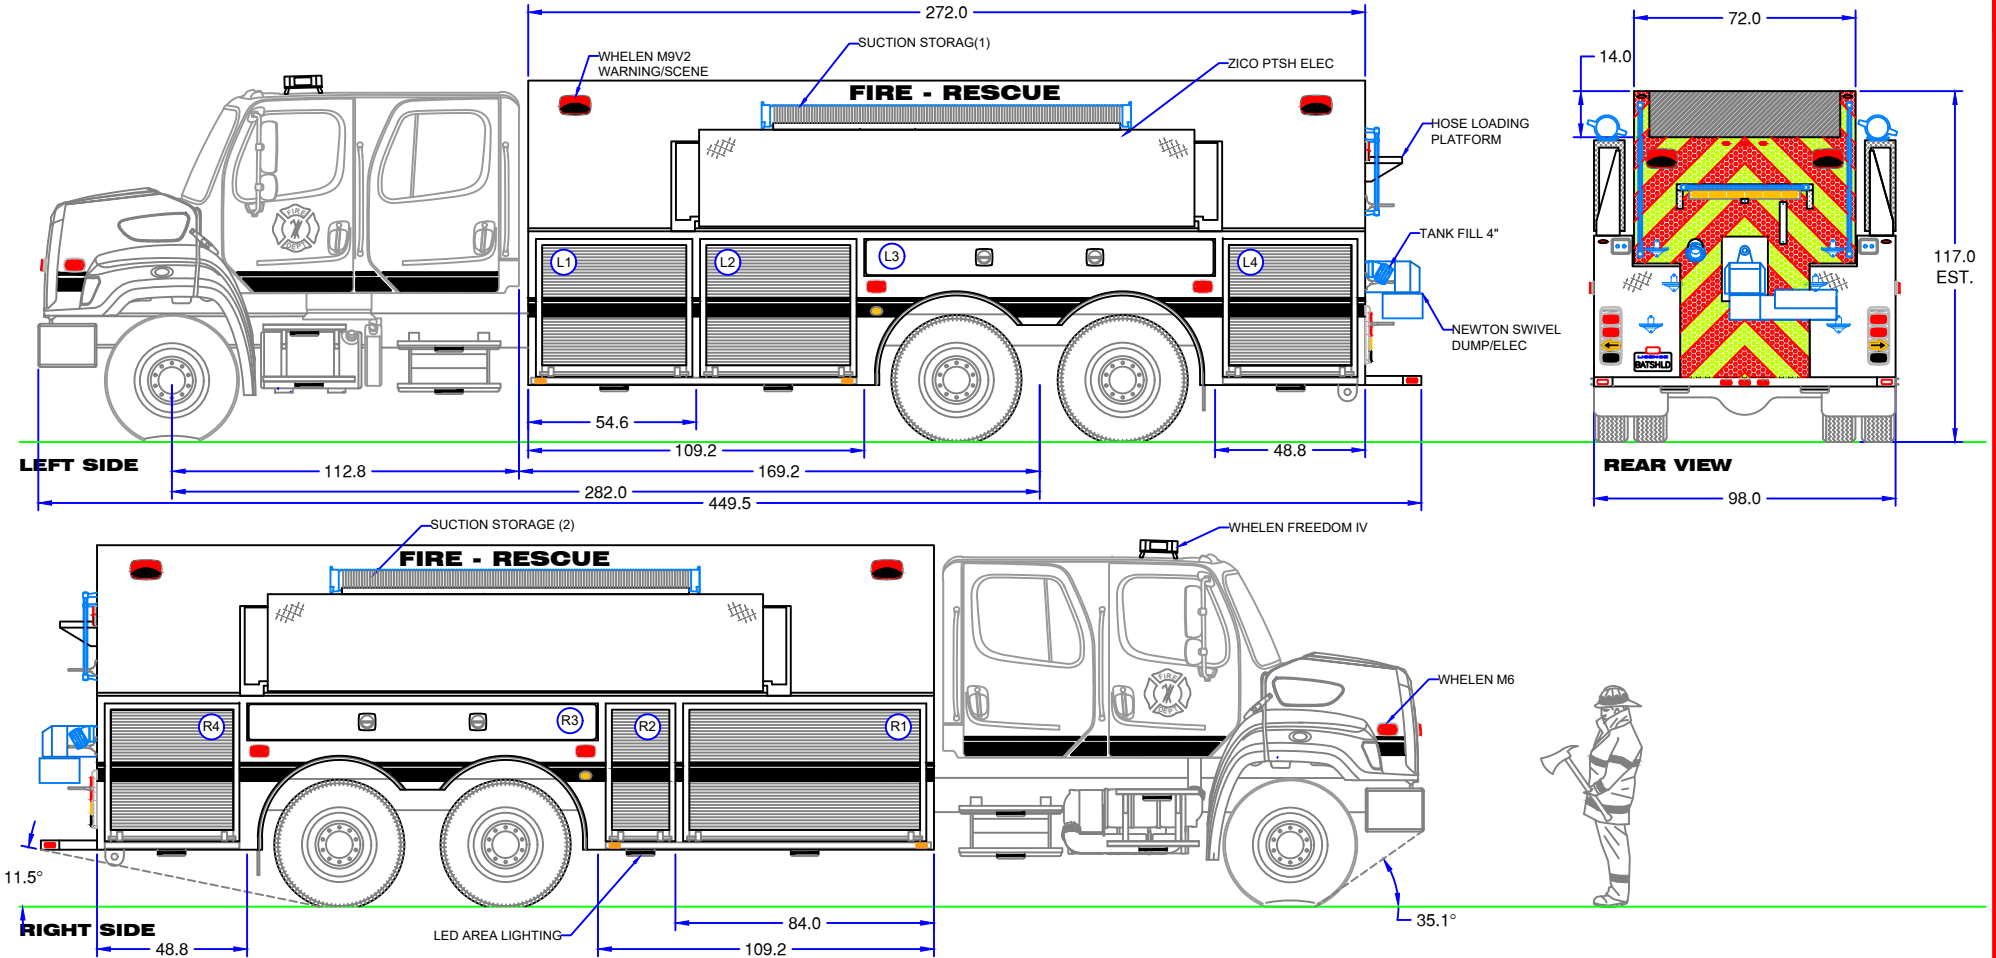

CAB

CHASSIS 2018 FREIGHTLINER 108SD CREW
 ENGINE CUMMINS ISL 9
 400 HP @ 2100 RPM
 1250 FT/LBS @ 1400 RPM

TRANS ALLISON 3000 EVS-P AUTO
 FAWR 16,000 LBS
 RAWR 48,000 LBS
 GAWR 64,000 LBS

BODY

BODY MAT'L 3/16" 5052-H32 MARINE GRADE ALUMINUM
 CHECKER 1/8" 3003H22 ALUMINUM CHECKER PLATE

DOORS AMDOR ROLL UP

OPTIONS INTERNAL STORAGE X 2 PORT-A-TANK
 NEWTON ELEC DUMP VALE W/SWIVEL
 FLIP DOWN CHUTE

FIRE PUMP & WATER TANK

FIRE PUMP N/A

FOAM SYS N/A

TANK 3000 IGAL POLY WET-SIDE

NOTE: ALL TRAYS/SHELVES OPTIONAL

	COMPARTMENT Dimensions		
	WIDTH	DEPTH	HEIGHT
L1	53.7	28.0	44.0
L2	53.7	28.0	44.0
L3	117.0	28.0	10.0
L4	46.0	28.0	44.0
R1	84	28.0	44.0
R2	23.3	28.0	44.0
R3	117.0	28.0	10.0
R4	46.0	28.0	44.0

SOUTH DUNDAS

ALL DIMENSIONS IN INCHES
 UNLESS OTHERWISE SPECIFIED
 DO NOT SCALE DRAWING

DISCLAIMER
 We reserve the right to modify these dimensions
 to accommodate actual "as built" chassis dimensions.
 This was prepared using body builder reference
 drawings.

DRAWN D. HE	DATE 04 JUL 2018
REVISED As-Built	
APPROVED L. THIBAUT	