


# AS BUILT DRAWING

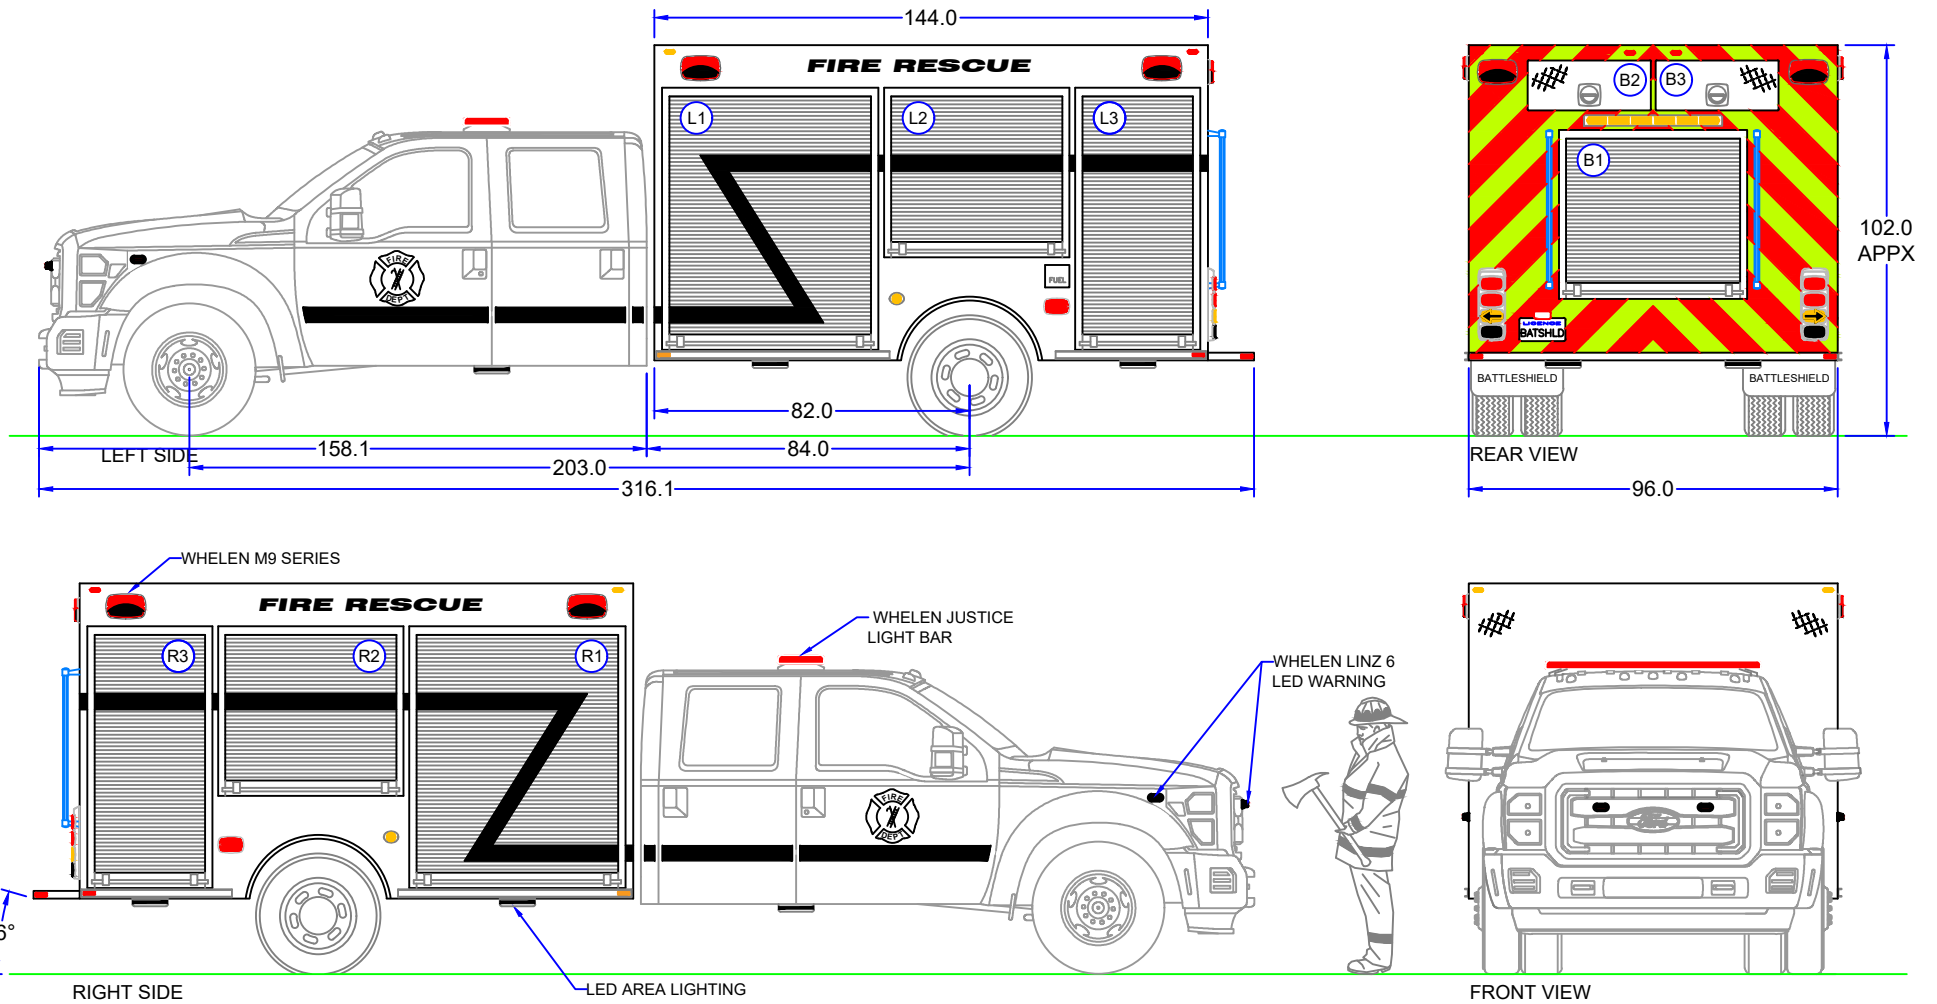

## WALK AROUND RESCUE PROPOSAL

**CAB**  
**CHASSIS** 2019 F550 4X4 SD CREW  
**ENGINE** 6.8L SOHC EFI NA V10  
 288 HP @ 4000 RPM  
 424 FT/LBS 3000 RPM  
**TRANSMISSION** 6 SPEED AUTOMATIC  
**GVWR** 19,500 LBS MAX  
**FGAWR** 6,000 LBS  
**RGAWR** 14,706 LBS

**BODY**  
**BODY MAT'L** 3/16" 5052 H32 ALM.  
 1/8" 5052 H32 ALM. CHECKER PLATE NFPA  
**WHELEN LED LIGHT PACKAGE**  
**WHELEN LED SCENE LIGHTS**  
**AMDOR ROLL-UP DOORS**  
**ALL TRAYS & SHELVES INCLUDED**

COMPARTMENT DIMENSIONS			
	WIDTH	HEIGHT	DEPTH
L1	59.8	77.8	69/23
L2	47.3	53.8	23.0
L3	33.8	77.8	23.0
R1	59.8	77.8	27/23
R2	47.3	53.8	23.0
R3	33.8	77.8	23.0

COMPARTMENT DIMENSIONS			
	WIDTH	HEIGHT	DEPTH
B1	48.0	48.6	83.8
B2	30.0	15.8	83.8
B3	30.0	15.8	83.8

ALL DIMENSIONS IN INCHES  
**DO NOT SCALE DRAWING**  
**DISCLAIMER**  
 We reserve the right to modify these dimensions to accommodate actual "as built" chassis dimensions. This was prepared using body builder reference drawings.  
**INSPECTED** L. THIBAUT DATE 23 MAY 2018  
**DRAWN** D. HE 23 MAY 2018  
**LAST UPDATE** D. HE 16 APR. 2019

