
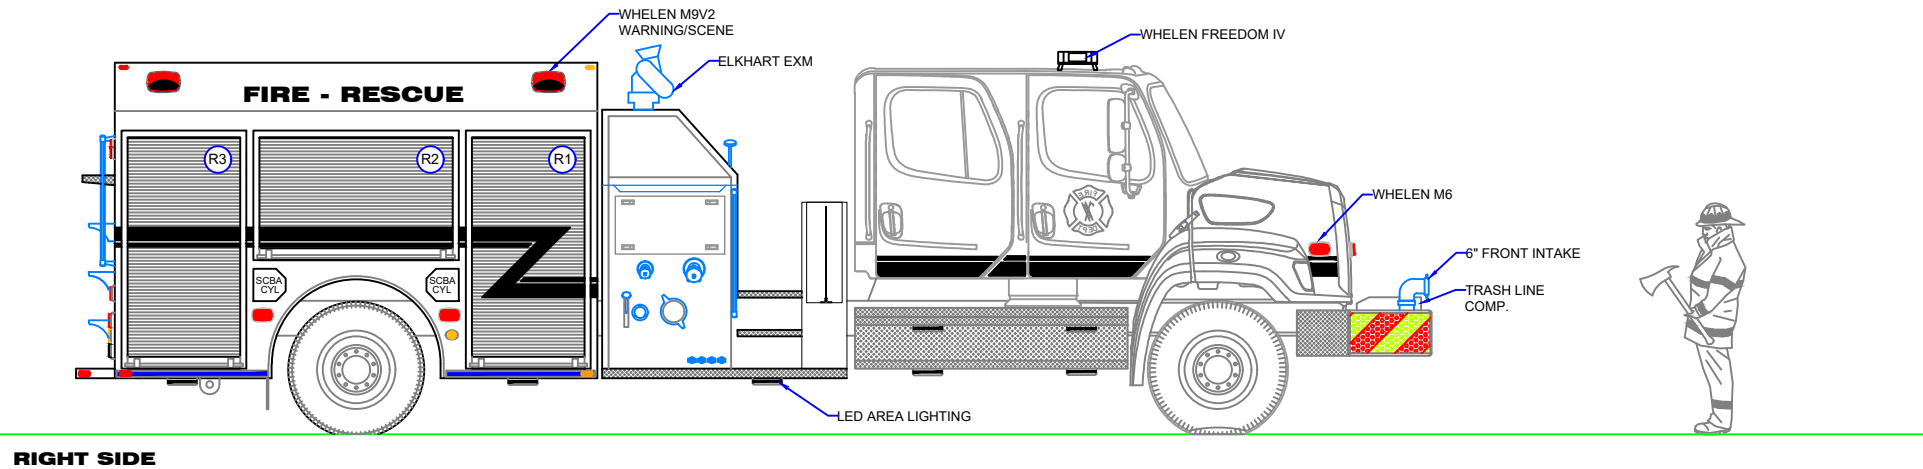


AS-BUILT

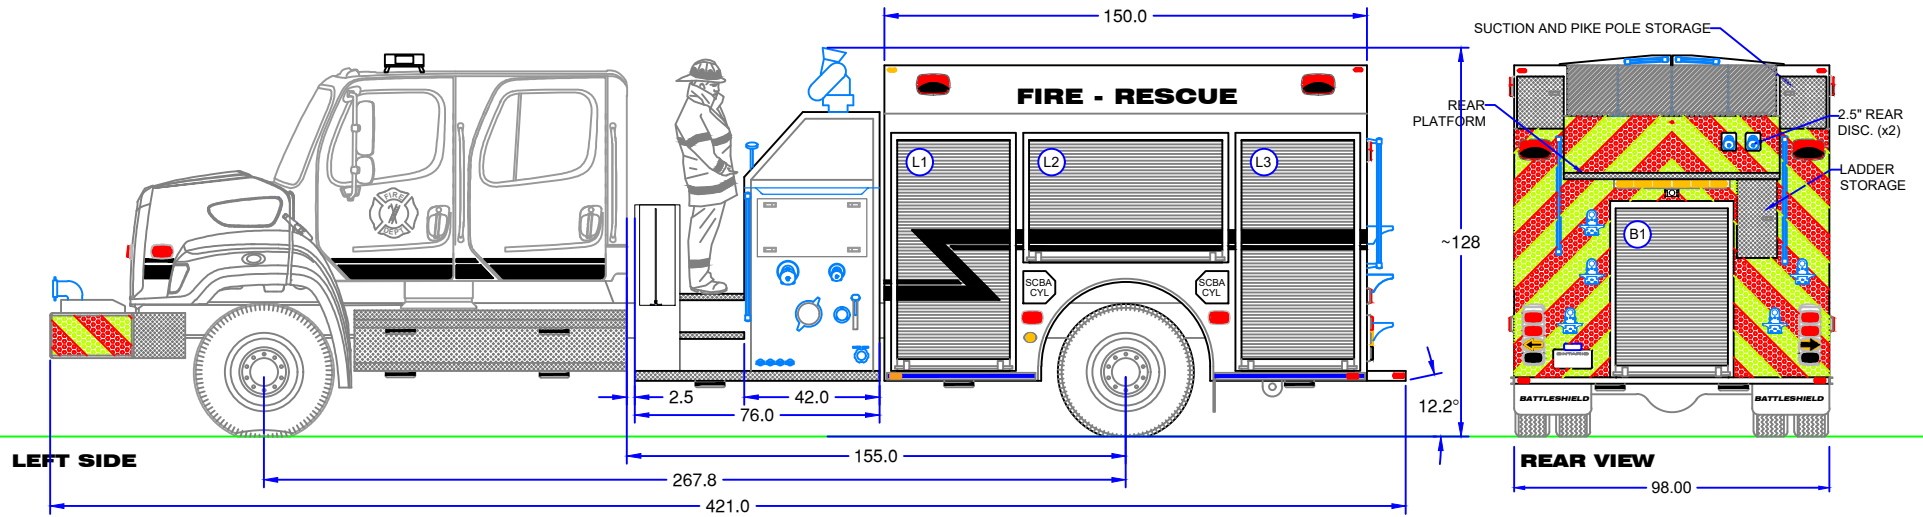

SOUTH STORMONT - PR (TOP MOUNT)

CAB
 CHASSIS 2020 FREIGHTLINER 108SD CREW
 ENGINE CUMMINS ISL 9
 400 HP @ 2100 RPM
 1250 LBS/FT @ 1400 RPM

TRANS ALLISON 3000 EVS-P AUTO
 FAWR 18,000 LBS
 RAWR 31,000 LBS
 GAWR 49,000 LBS

BODY
 BODY MAT'L 3/16" 5052 H32 ALUMINUM
 CHECKER 1/8" 3003H22 ALUMINUM CHECKER PLATE

DOORS AMDOR ROLL UP

OPTIONS STORAGE FOR 2 X SUCTION HOSE
 2 1/2" REAR DISCHARGE RIGHT AND LEFT SIDE
 6" FRONT INTAKE RIGHT SIDE

FIRE PUMP & WATER TANK
 FIRE PUMP HALE QMAX XS 5000 LPM

FOAM SYS FOAM PRO 2001

TANK 1000 IGAL POLY DRY-SIDE
 25 IGAL FOAM

NOTE: ALL TRAYS/SHELVES OPTIONAL

COMPARTMENT	Dimensions REF.		
	WIDTH	DEPTH	HEIGHT
L1	42.0	27.0/15.0	74.0
L2	66.0	27.0/15.0	44.0
L3	42.0	27.0/15.0	74.0
R1	42.0	27.0/15.0	74.0
R2	66.0	27.0/15.0	44.0
R3	42.0	27.0/15.0	74.0
B1	42.0	24.0	60.0

ALL DIMENSIONS IN INCHES
 UNLESS OTHERWISE SPECIFIED
DO NOT SCALE DRAWING

DISCLAIMER
 We reserve the right to modify these dimensions
 to accommodate actual "no ball" chassis dimensions.
 This was prepared using body builder reference
 drawings.

DRAWN D. HE
REVISION
 As-Built
APPROVED L. THIBAUT

DATE 07 JAN 2021
LAST UPDATE

