


P/T MEDIUM SIDE

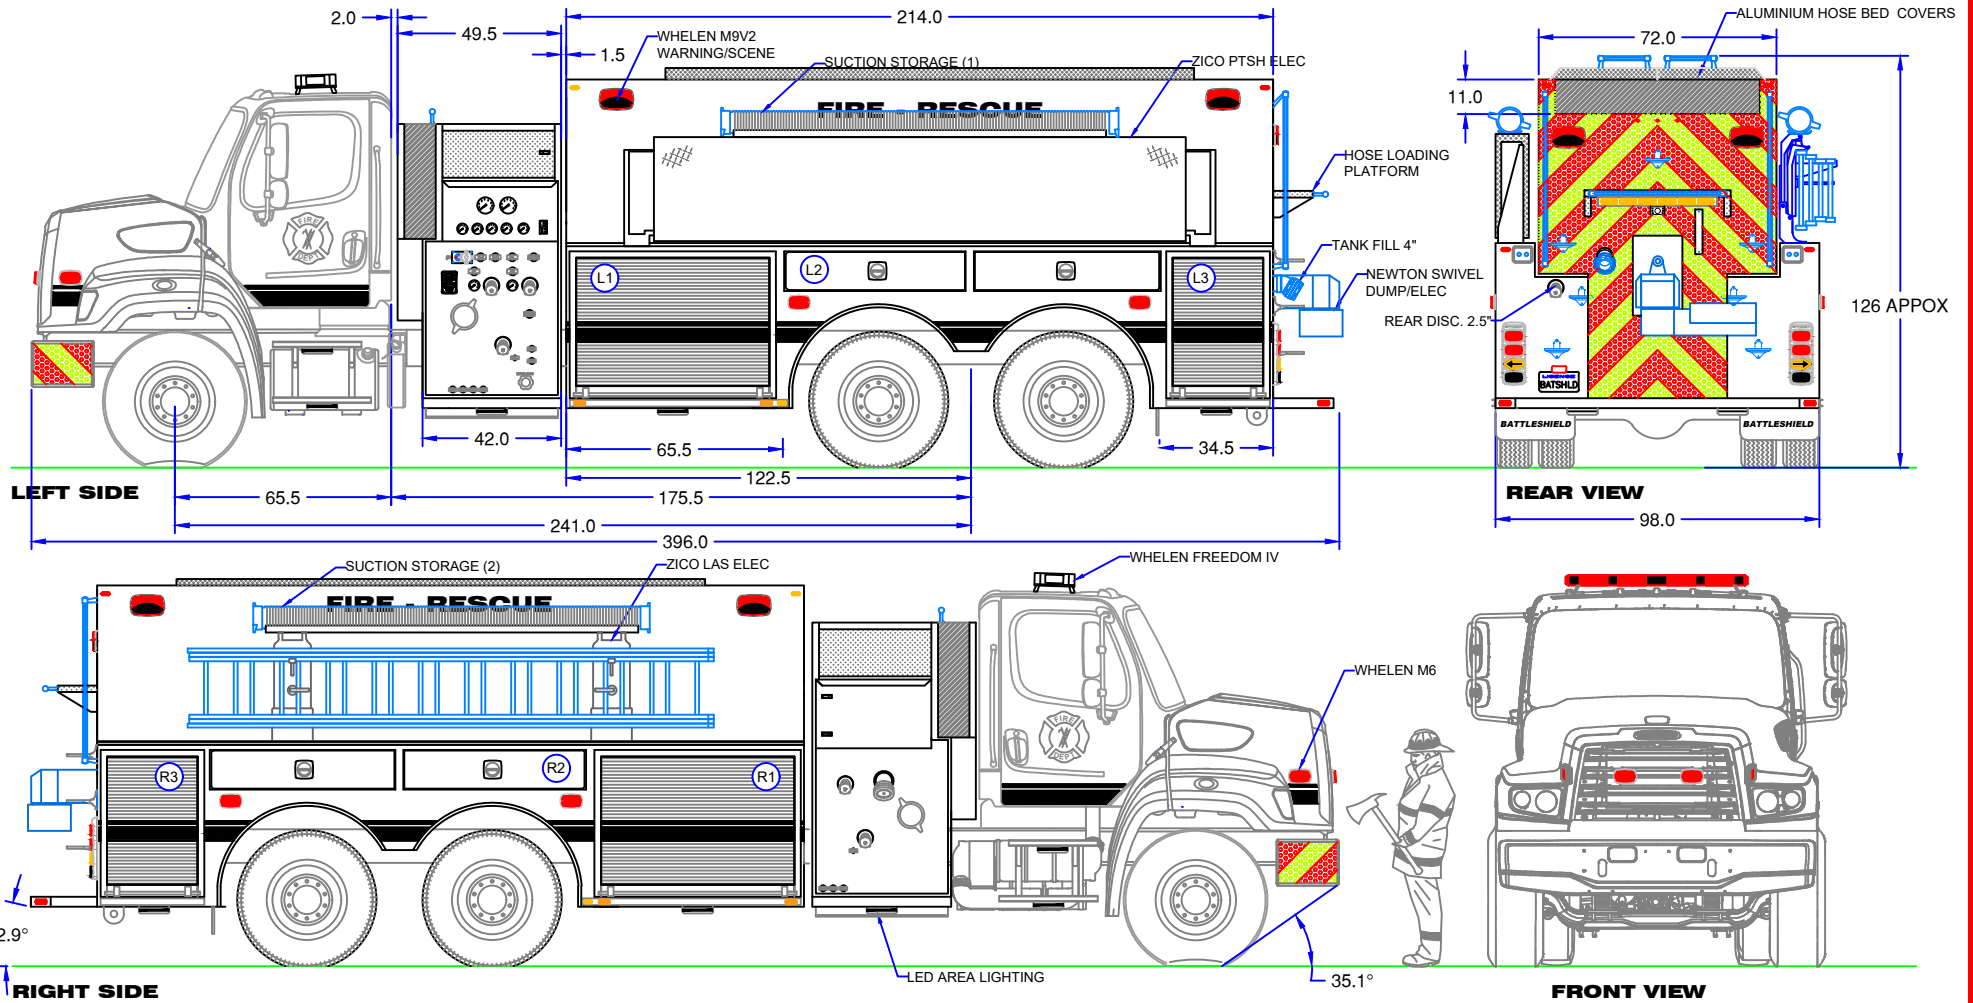

CAB
 CHASSIS 2022 FREIGHTLINER 108 SD
 ENGINE CUMMINS L9 EV
 400 HP @ 2100 RPM
 1250 FT/LBS @ 1400 RPM

TRANS ALLISON 3000 EVS-P AUTO
 FAWR 16,000 LBS
 RAWR 44,000 LBS
 GAWR 60,000 LBS

BODY
 BODY MATL 3/16" 5052-H32 MARINE GRADE ALUMINUM
 CHECKER 1/8" 3003H22 ALUMINUM CHECKER PLATE

DOORS AMDOR ROLL DOORS

OPTIONS ZICO ELECTRIC LADDER RACK
 ZICO ELECTRIC PORT-A-TANK RACK
 STORAGE FOR 2 X SUCTION HOSE
 2 1/2" REAR DISCHARGE

FIRE PUMP & WATER TANK
 FIRE PUMP HALE QMAX XS 5000 LPM

FOAM SYS FOAMPRO 2001

TANK: 2500 IGAL POLY DRY-SIDE
 25 IGAL FOAM

NOTE: ALL TRAYS/SHELVES INCLUDED

COMPARTMENT Dimensions			
	WIDTH	DEPTH	HEIGHT
L1	58.75	28.0	37.375
L2	111.5	28.0	9
L3	27.75	28.0	37.375
R1	58.75	28.0	37.375
R2	111.5	28.0	9
R3	27.75	28.0	37.375

DO NOT SCALE DRAWING

1394-NORTH GLENGERRY

ALL DIMENSIONS IN INCHES
 UNLESS OTHERWISE SPECIFIED
 DO NOT SCALE DRAWING

DISCLAIMER

We reserve the right to modify these dimensions
 to accommodate actual "as built" chassis dimensions.
 This was prepared using body builder reference
 drawings.

DRAWN	D. HE	DATE	23 NOV 2017
REVISED			
APPROVED	A. THANKACHAN	DATE	02 NOV 2021
	L. THIBAUT		

